VERIFICATION OF MEASUREMENTS:

IT SHALL BE THE CONTRACTORS RESPONSIBILITY TO VERIFY ALL DIMENSIONS & MAKE NECESSARY ADJUSTMENTS PRIOR & DURING CONSTRUCTION.

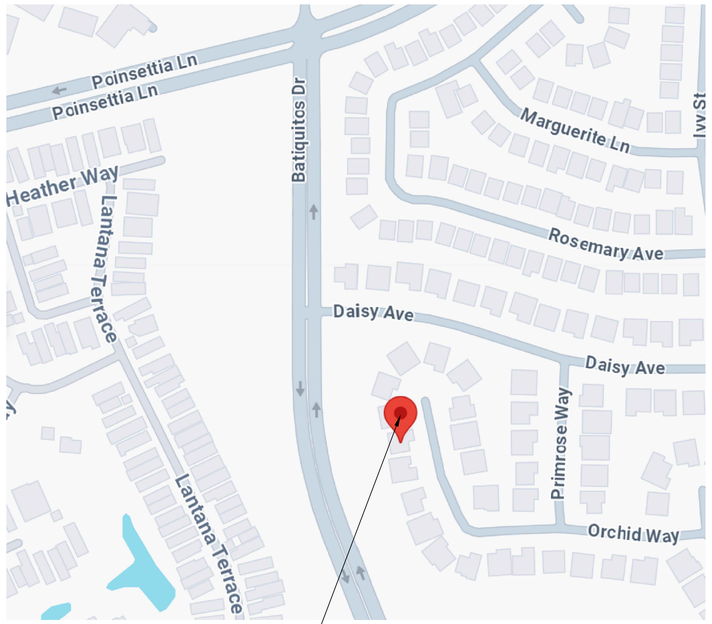

907 Orchid Way
Carlsbad CA 92011

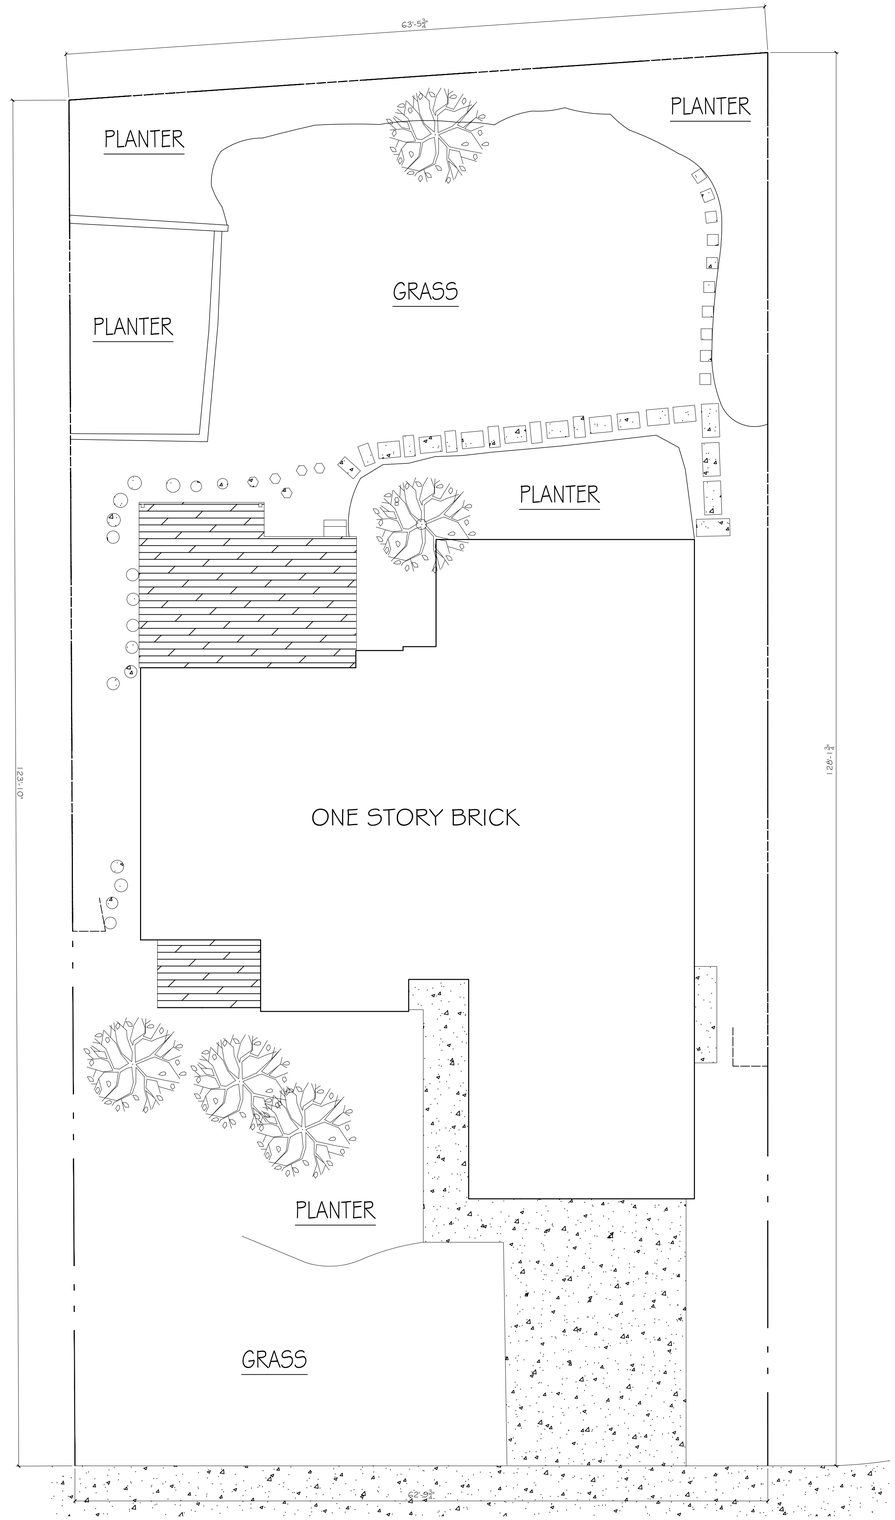

1 SITE PLAN
SCALE: 1/4" = 1' - 0"

907 Orchid Way Carlsbad CA 92011.dwg

1/15/2004

ISSUE RECORD:

DRAWN BY:	Jason S. Pishva	DATE:	ISSUED FOR:
CHKD BY:			COMMENTS:
DWG FILE:	907 ORCHID WAY CARLSBAD CA 92011.DWG		

Confidential/Copyright (c) BY US AS-BUILT DRAFTING 2002222

US AS _ BUILT
1210 0 Wilshire Boulevard
Los Angeles, CA 90025
(310) 993-5454
info@audesigndrafting.com

US AS-BUILT

AS _ BUILT DRAWINGS
907 Orchid Way
Carlsbad CA 92011

SHEET CONTENTS:
SITE PLAN,

DATE: 10-10-2014

A01

VERIFICATION OF MEASUREMENTS:

IT SHALL BE THE CONTRACTORS RESPONSIBILITY TO VERIFY ALL DIMENSIONS & MAKE NECESSARY ADJUSTMENTS PRIOR & DURING CONSTRUCTION.

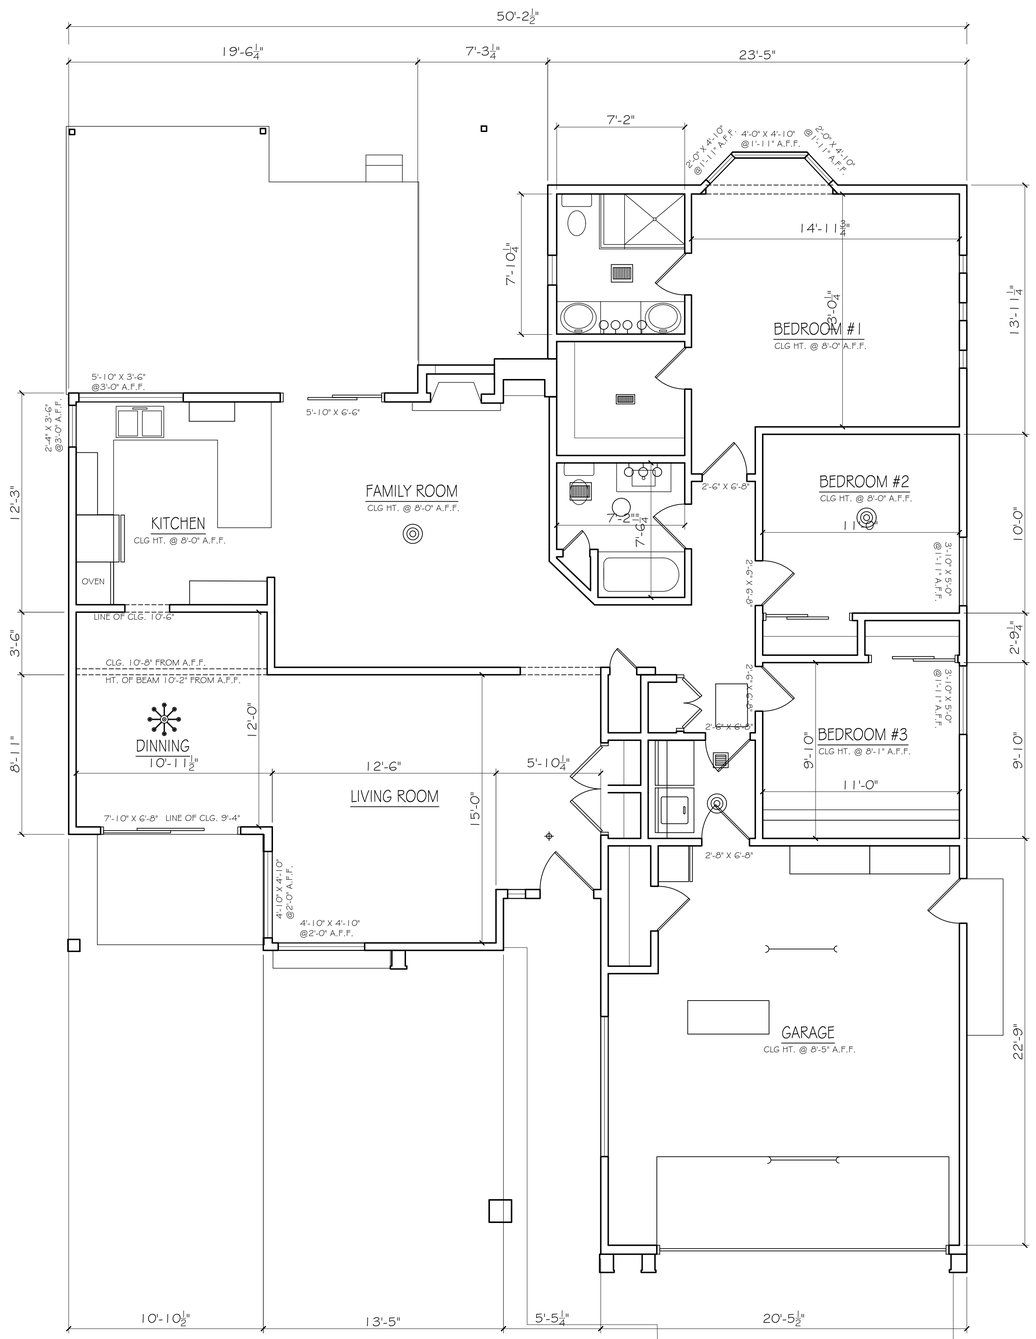

1 FLOOR PLAN

SCALE: 1/4" = 1' - 0"

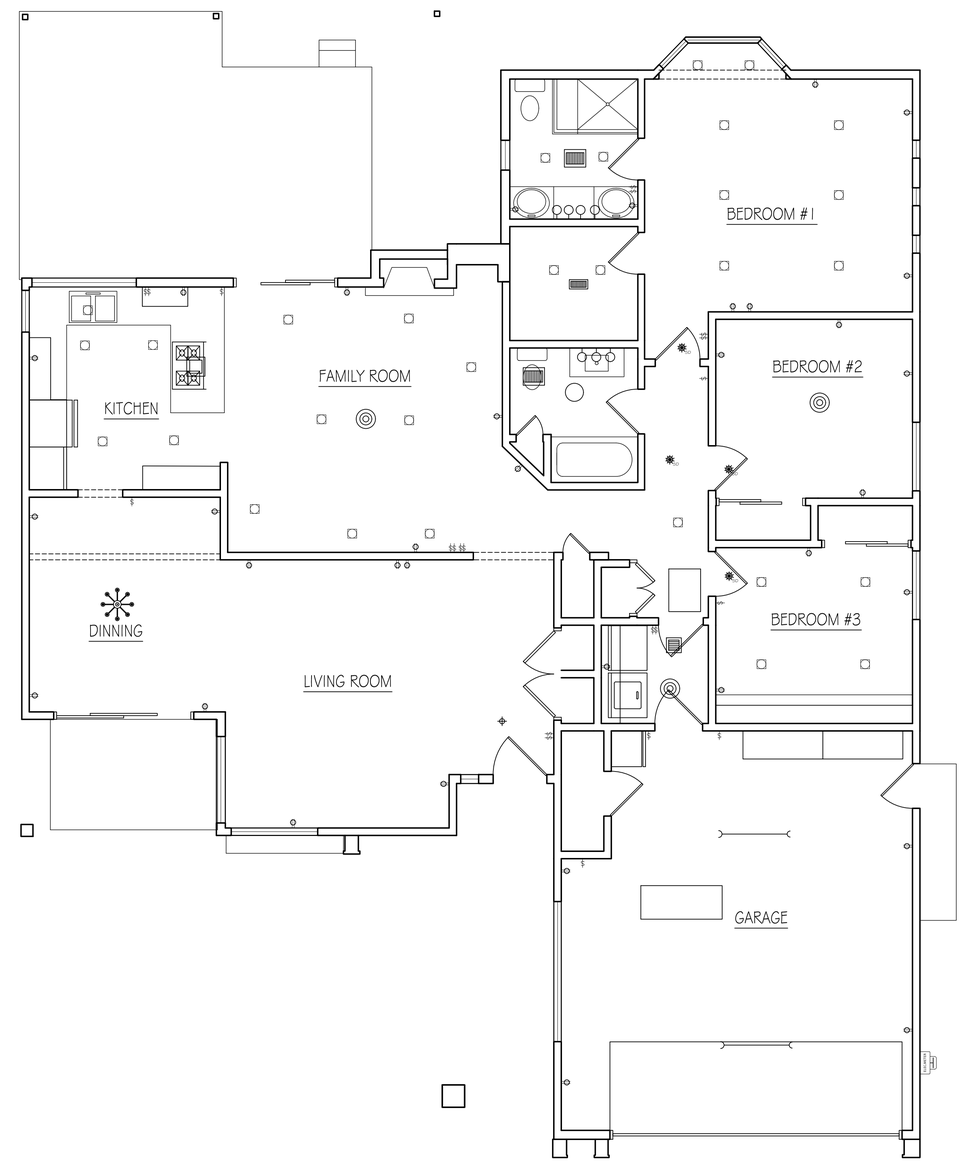

2 REFLECTED CEILING PLAN

SCALE: 1/4" = 1' - 0"

907 Orchid Way Carlsbad CA 92011.dwg

1/15/2004

ISSUE RECORD:

DRAWN BY:	Jason S. Pishva	DATE:	ISSUED FOR:
CHKD BY:			COMMENTS:
DWG FILE:	907 ORCHID WAY CARLSBAD CA 92011.DWG		

Confidential/Copyright (c) BY DESIGN DRAFTING 2002222

US AS _ BUILT
12100 Wilshire Boulevard
Los Angeles, CA 90025
(310) 993-5454
info@audesigndrafting.com

US AS-BUILT

AS _ BUILT DRAWINGS
907 Orchid Way
Carlsbad CA 92011

SHEET CONTENTS:
FLOOR PLAN,

DATE: 10-10-2014

A02

VERIFICATION OF MEASUREMENTS:

IT SHALL BE THE CONTRACTORS RESPONSIBILITY TO VERIFY ALL DIMENSIONS & MAKE NECESSARY ADJUSTMENTS PRIOR & DURING CONSTRUCTION.

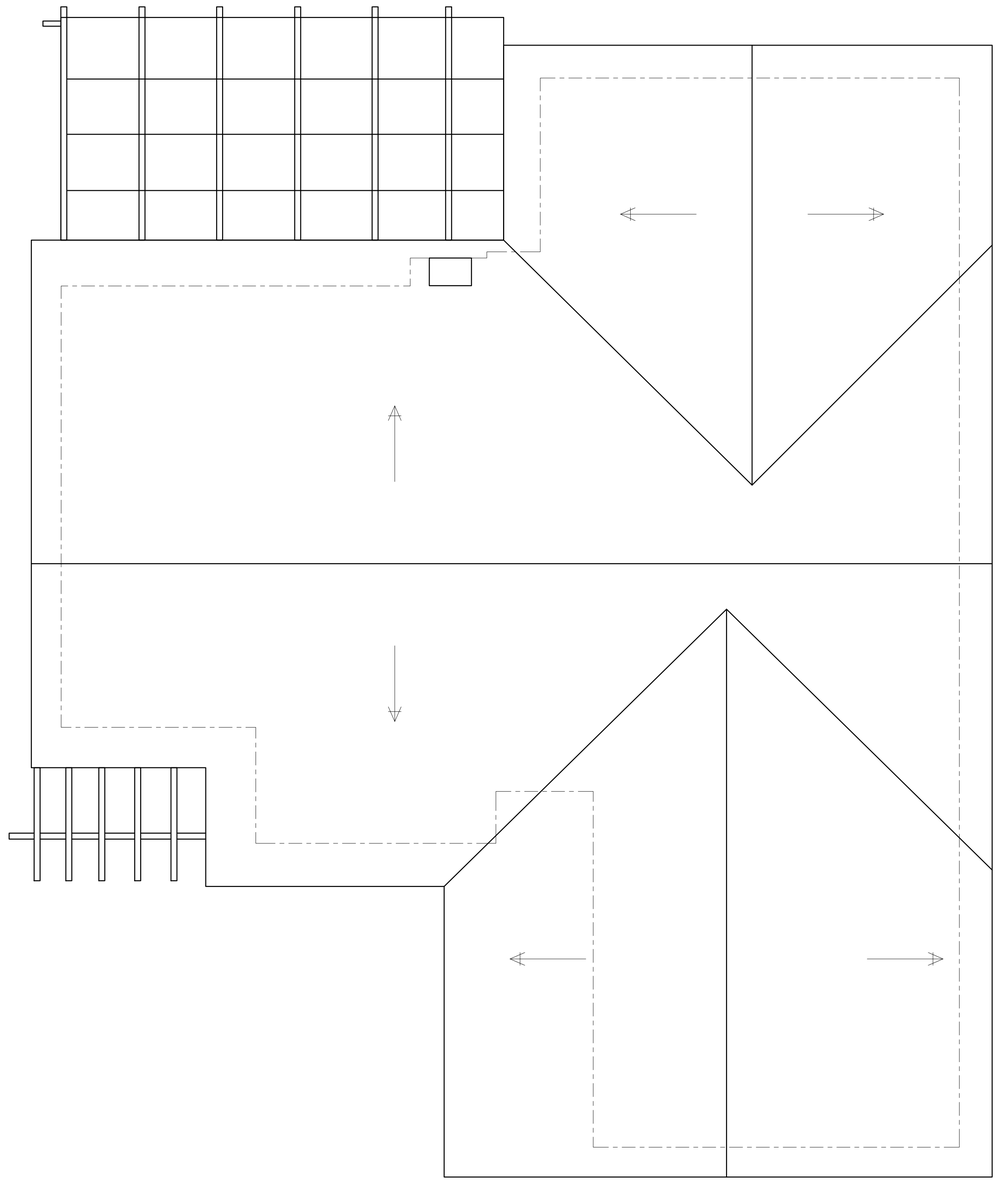

1 ROOF PLAN
SCALE: 1/4" = 1' - 0"

907 Orchid Way Carlsbad CA 92011.dwg

1/15/2004

ISSUE RECORD:

DRAWN BY:	Jason S. Pishva	DATE:	ISSUED FOR:
CHKD BY:			COMMENTS:
DWG FILE:	907 ORCHID WAY CARLSBAD CA 92011.DWG		

Confidential/Copyright (c) BDVDCAD DRAFTING 2002222

US AS _ BUILT
12100 Wilshire Boulevard
Los Angeles, CA 90025
(310) 993-5454
info@audesigndrafting.com

US AS-BUILT

AS _ BUILT DRAWINGS
907 Orchid Way
Carlsbad CA 92011

SHEET CONTENTS:
ROOF PLAN,

DATE: 10-10-2014

A03

VERIFICATION OF MEASUREMENTS:

IT SHALL BE THE CONTRACTORS RESPONSIBILITY TO VERIFY ALL DIMENSIONS & MAKE NECESSARY ADJUSTMENTS PRIOR & DURING CONSTRUCTION.

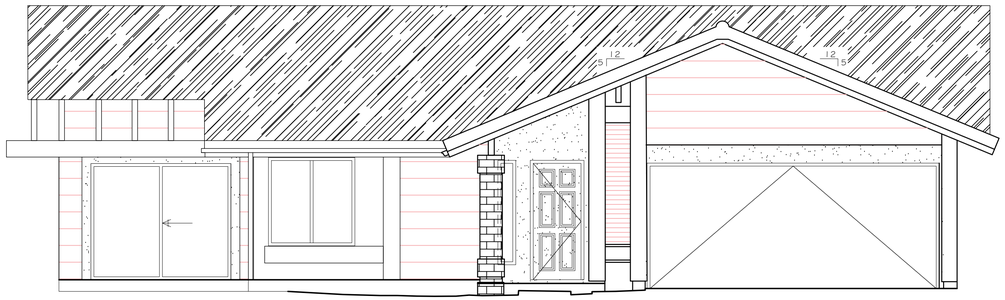

1 EAST ELEVATION
SCALE: 1/4" = 1' - 0"

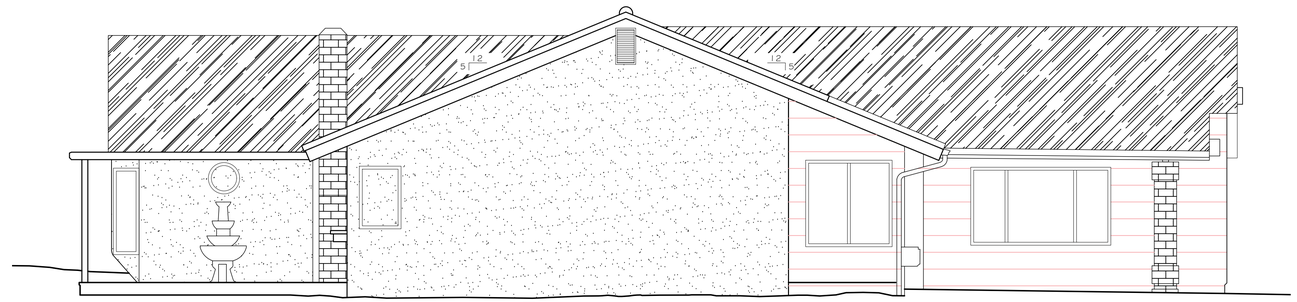

2 SOTUH ELEVATION
SCALE: 1/4" = 1' - 0"

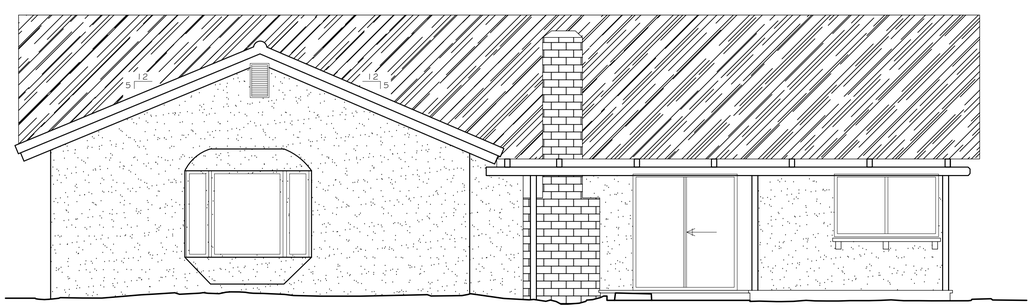

3 WEST ELEVATION
SCALE: 1/4" = 1' - 0"

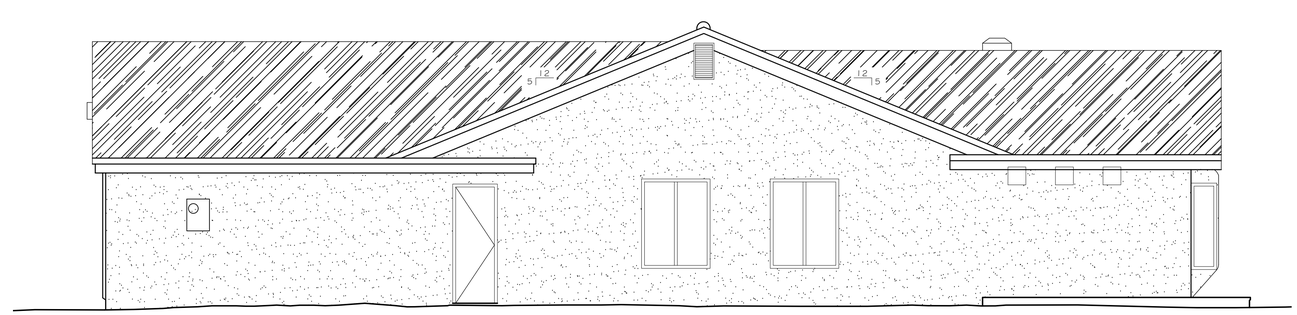

4 NORTH ELEVATION
SCALE: 1/4" = 1' - 0"

907 Orchid Way Carlsbad CA 92011.dwg

1/15/2004

ISSUE RECORD:

DRAWN BY:	Jason S. Pishva	DATE:	ISSUED FOR:
CHKD BY:			COMMENTS:
DWG FILE:	907 ORCHID WAY CARLSBAD CA 92011.DWG		

Confidential/Copyright (c) BDVDesign DRAFTING 2002222

US AS _ BUILT
12100 Wilshire Boulevard
Los Angeles, CA 90025
(310) 993-5454
info@audesigndrafting.com

US AS-BUILT

AS _ BUILT DRAWINGS
907 Orchid Way
Carlsbad CA 92011

SHEET CONTENTS:
elevations PLAN,

DATE: 10-10-2014

A04